


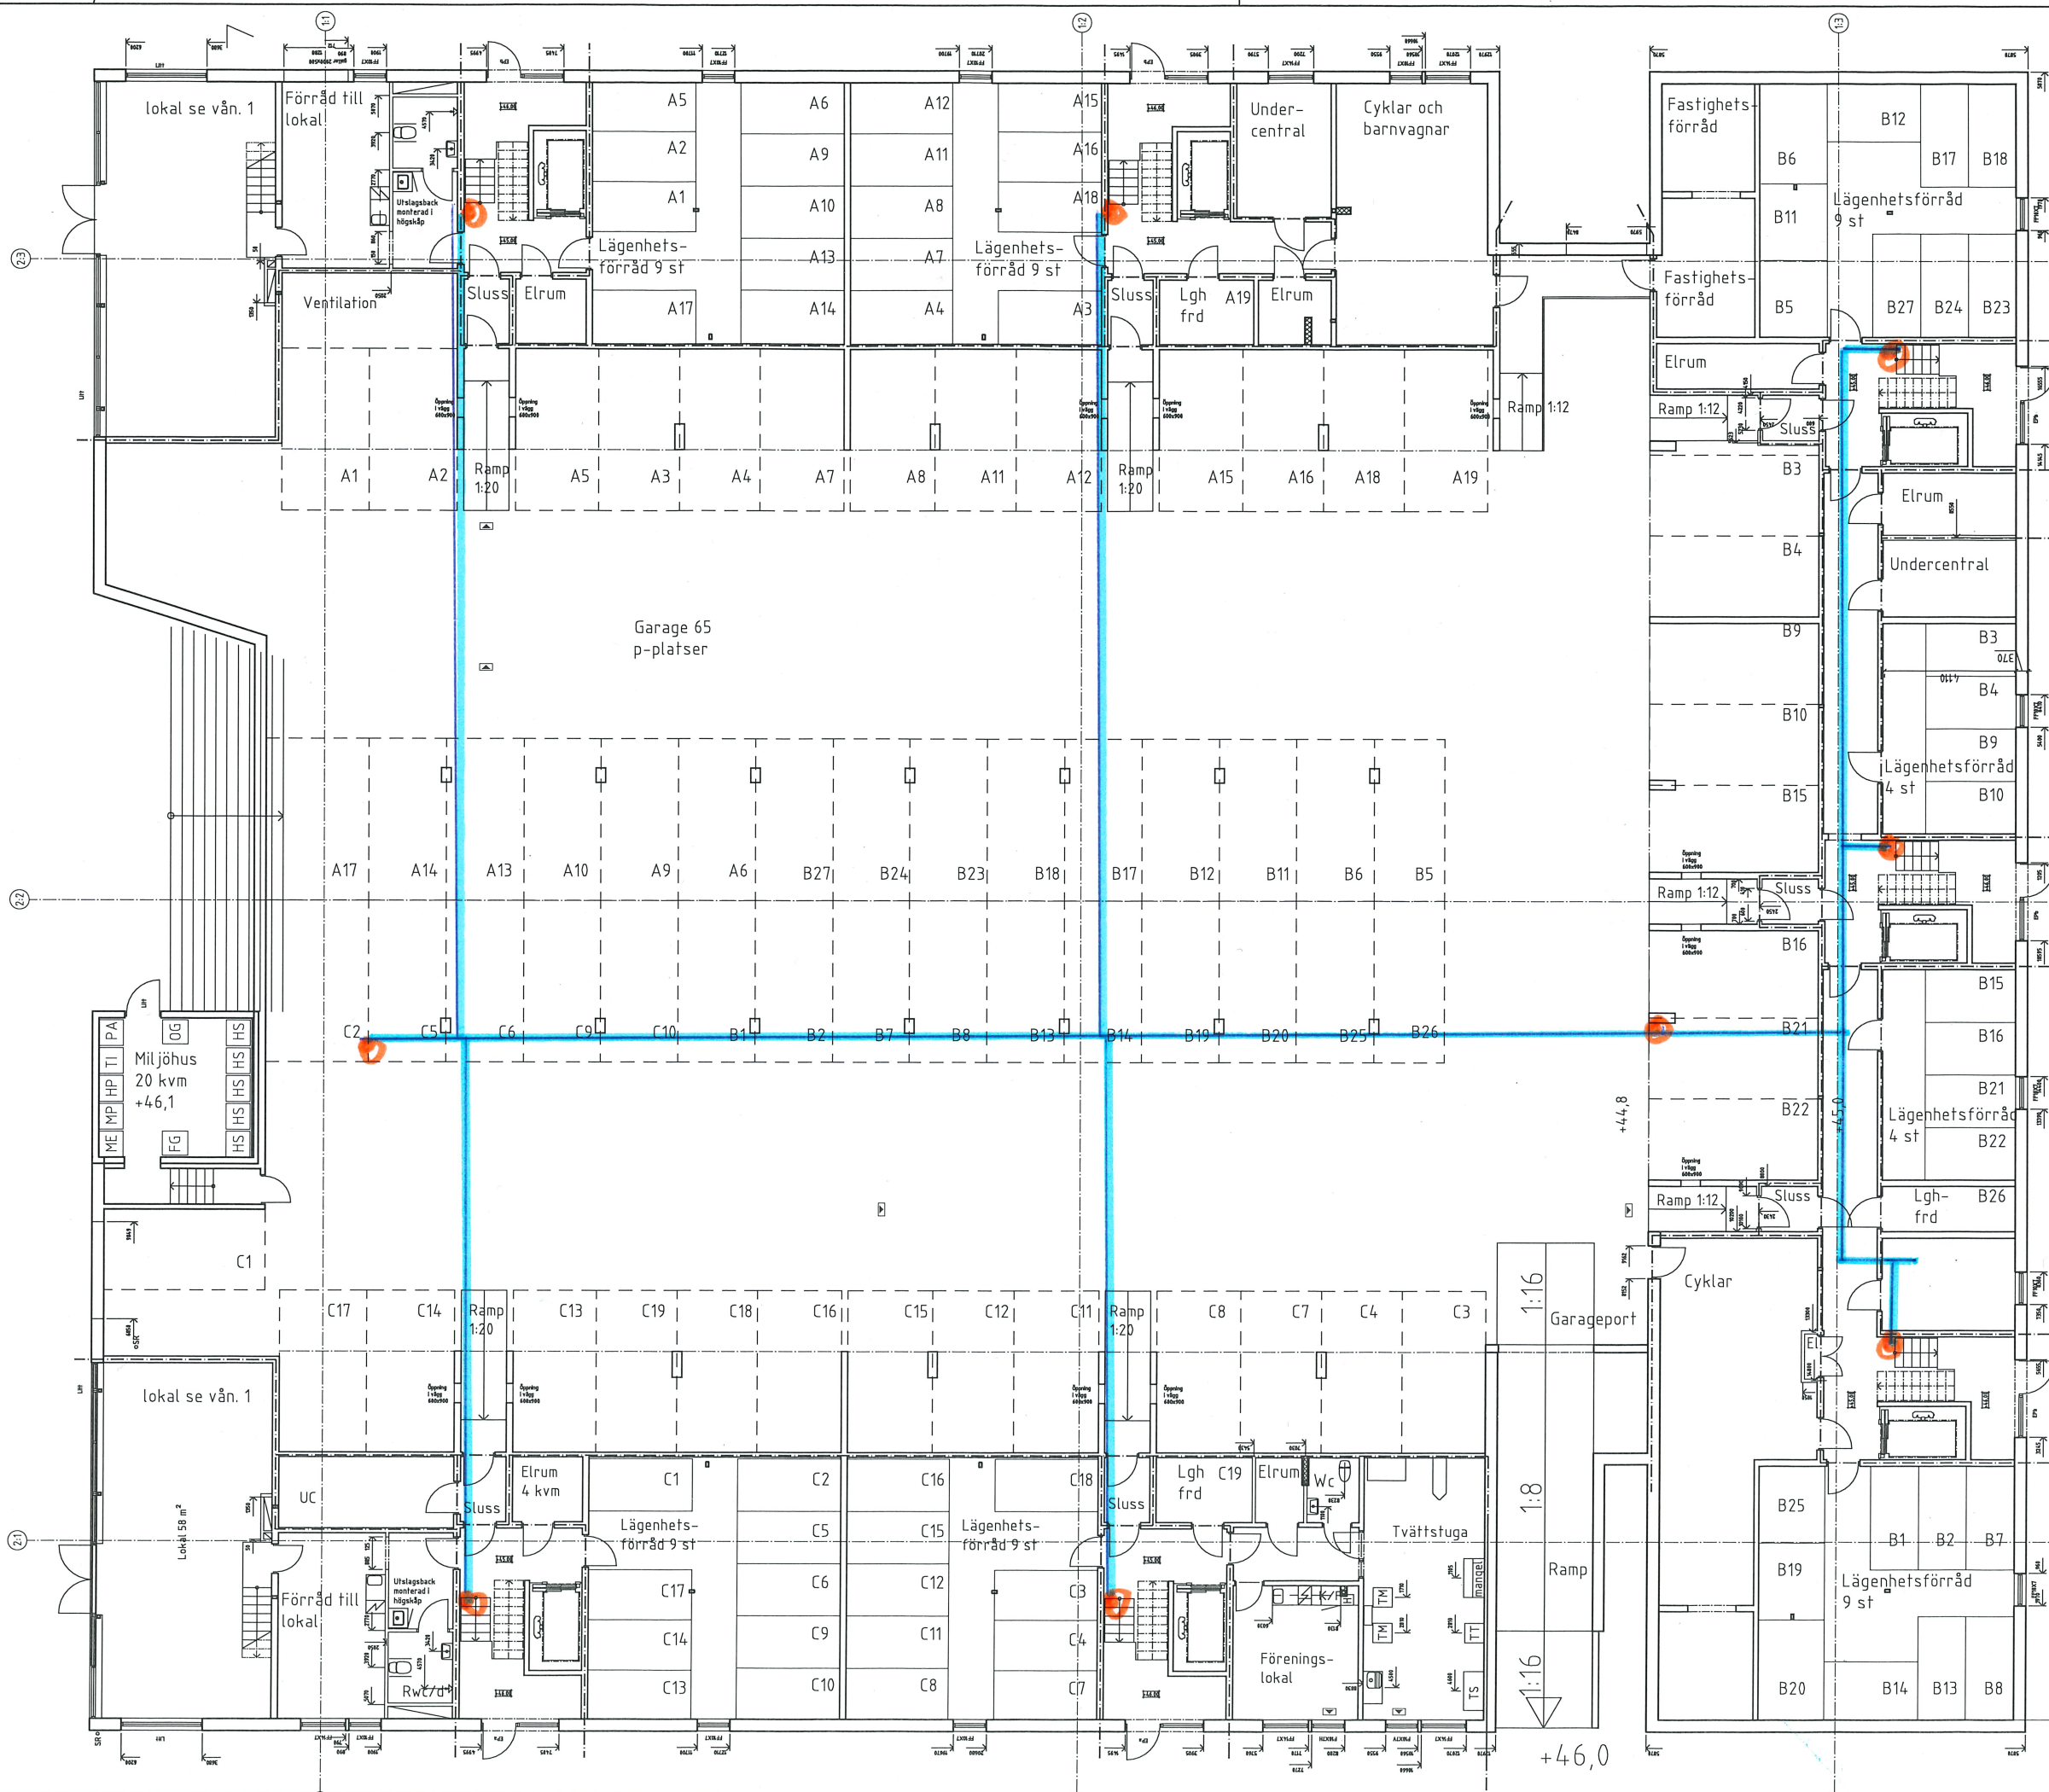

Kanara

8 81m

10 62m

12 36m

14 18m

16 3m

18 53m

20 73m

soprum 58m

garage 18m

Tot kabel. 402m

Kash. kabel +
skyddsrör
+ klammer
ca 6000 kr

BET	ANT	ÄNDRINGEN AVSER	DATUM	SIGN
RELATIONSHANDLING				
Brf Inre Hamnen Kv. Barkassen, Karlstad				
 Sverigehuset			T.031-7750320 F.031-7753875	
			T.054-183800 F.054-240646	
A	ABAKO Arkitektkontor AB		T.031-856700	F.031-856701
K	Granruds Konstruktionsbyrå		T.054-156850	F.054-188952
VENT	KVE Konsult AB		T.054-102045	F.054-158844
VS	Värmetekniska Byrå AB		T.054-156545	F.054-189926
E	ÄF Infrastruktur AB		T.054-170971	F.054-101931
PREFAB	A-betong AB		T.0346-55413	F.0346-19871
B	Bengt Dahlgrens AB		T.031-7202681	F.031-7202501
M			--	--
UPPDRAG NR BYB00601		RITAD/KONSTR AV I. L.M.KADES JÖ		HANDLÄGGARE I. LUNDBERG
DATUM 08-09-09		ANSVARIG <i>Glas Dräffer</i>		
Hus A, Hus B, Hus C				
Plan				
Källarvåning				
CAD AutoCAD 2000	SKALA A1 1:100 A3 1:200	NUMMER A40.1-001		BET

